

FOUNDATION SURVEY

LOCATED AT 3436 NW CORONADO ST.
LOT 48 OF "CORONADO", CITY OF
CORVALLIS, OREGON

PREPARED BY
COLE SURVEYING, LLC
245 NE CONIFER BLVD.
CORVALLIS, OREGON 97330
(541) 929-5500


FOR: DOD ENTERPRISES, LLC

DATE: JUNE 30, 2015

SCALE: 1" = 30'

LEGEND

- FOUND 5/8" IRON ROD PER "CORONADO" SUBDIVISION PLAT
- () RECORD INFORMATION PER "CORONADO" SUBDIVISION PLAT, RECORD AGREES WITH MEASURED DATA

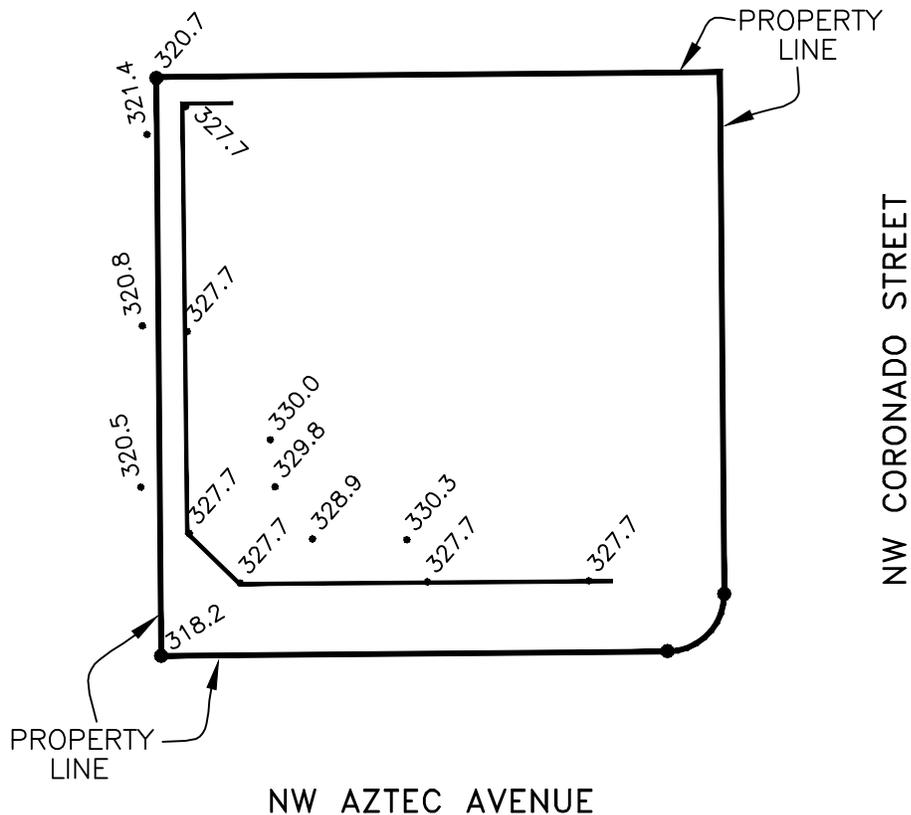

REGISTERED
PROFESSIONAL
LAND SURVEYOR

OREGON
JANUARY 11, 2005
BRIAN SCOTT SAILOR
61341

EXPIRES 6/30/16

I, BRIAN SAILOR, CERTIFY THAT I
HAVE CORRECTLY SURVEYED THE
WALL FORMS ON THIS PROPERTY
AS SHOWN HEREON AND THAT NO
PORTION, AS OF THIS DATE, LIES
OUTSIDE OF THE PROPERTY LINES
AS SHOWN.